


西田第2

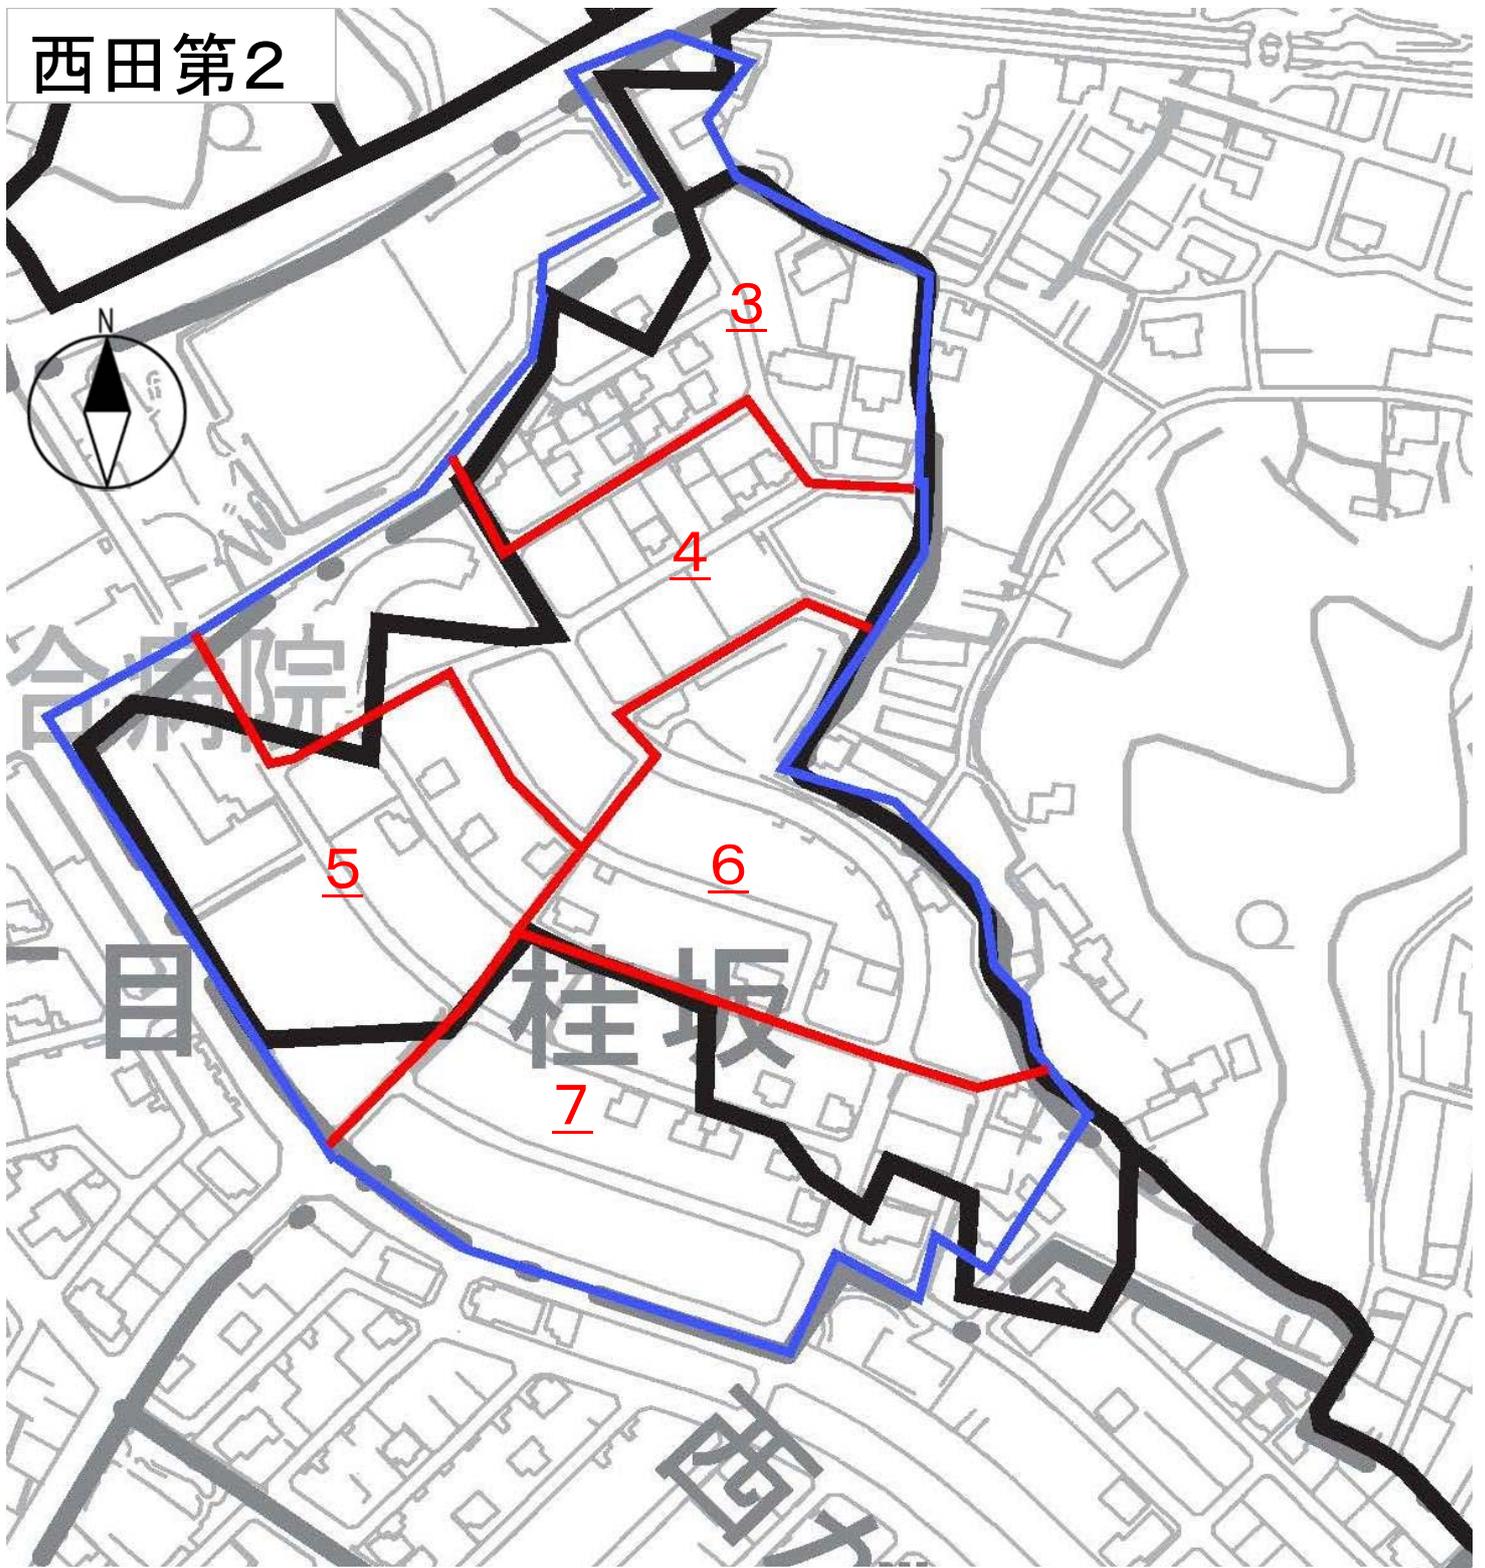

この頁は当地区の索引図（頁照合用）として本市職員が作成したものです。

□赤字は、頁（ページ）番号になります。


□青線は、この索引図の黒実線又は緑実線が区画整理の区域線と大きく異なる場合に、目安として明示したものです。

西田第二地区画地出来形確認測量原図

図面地番表

図面番号	地番							
NO.1	1-1	1-2	1-3	1-4	1-5	1-6	1-7	1-8
	1-9	1-10	1-11	1-12	1-13	1-14	1-15	
	2-1	2-2	2-3	2-4	2-5	2-6	2-7	2-8
	2-9	2-10						
	3-1	3-2	3-3	3-4	3-5	3-6	3-7	3-8
	3-9	3-10	3-11	3-12	3-13	3-14	3-15	3-16
	3-17	3-18	3-19	3-20				
	100	101	102	103	106			
	119							
	122-2							
	1715-3	1715-4	1715-5	1715-6				
	1722-4							
	1723-4							
1728-5								
NO.2	4-1							
	5-1	5-2	5-3	5-4	5-5	5-6	5-7	5-8
	5-9	5-10	5-11	5-12	5-13	5-14	5-15	5-16
	6-1	6-2	6-3	6-4	6-5	6-6	6-7	6-8
	6-9	6-10	6-11					
	9-1	9-2	9-3	9-4	9-5	9-6	9-7	9-8
	9-9	9-10						
	14-1							
	101	104	106	107	108	111		
	1728-5							
NO.3	10-1	10-2	10-3	10-4	10-5	10-6	10-7	10-8
	10-9	10-10	10-11	10-12	10-13	10-14		
	13-1	13-2	13-3	13-4	13-5	13-6	13-7	13-8
	13-9	13-10	13-11	13-12	13-13	13-14	13-15	
	15-1	15-2	15-3	15-4	15-5	15-6	15-7	15-8
	109	110	112	113	114			


図面番号	地番							
NO.4	7-1							
	8-1	8-2	8-3	8-4	8-5	8-6	8-7	8-8
	8-9	8-10	8-11	8-12	8-13	8-14	8-15	8-16
	8-17	8-18	8-19	8-20	8-21	8-22		
	11-1	11-2	11-3	11-4	11-5	11-6	11-7	11-8
	11-9	11-10	11-11	11-12	11-13	11-14	11-15	
	19-13	19-14	19-15	19-16	19-17	19-18	19-19	19-20
	104	105	106	108	109	116		
	1733-2							
	1734-2							
	1736-3	1736-4						
	1741-3							
	1742-5							
	1756-3	1756-4						
	NO.5	12-1	12-2	12-3	12-4	12-5	12-6	12-7
12-9		12-10	12-11	12-12	12-13	12-14	12-15	12-16
12-17		12-18	12-19	12-20	12-21	12-22		
16-1		16-2	16-3	16-4	16-5	16-6	16-7	16-8
16-9		16-10	16-11	16-12	16-13	16-14	16-15	16-16
16-17		16-18	16-19	16-20	16-21	16-22	16-23	16-24
16-25								
17-1		17-2	17-3	17-4	17-5	17-6	17-7	17-8
17-9		17-10	17-11	17-12	17-13	17-14	17-15	17-16
17-17		17-18	17-19	17-20	17-21	17-22	17-23	17-24
17-25		17-26						
18-1		18-2	18-3	18-4	18-5	18-6	18-7	18-8
19-10		19-11	19-12	19-21				
105		106						
110		115	116	117-2				

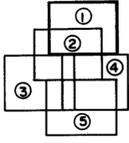

西田第二地区画地出来形確認測量原図

NO.1

Y=-28,450
X=-63,800

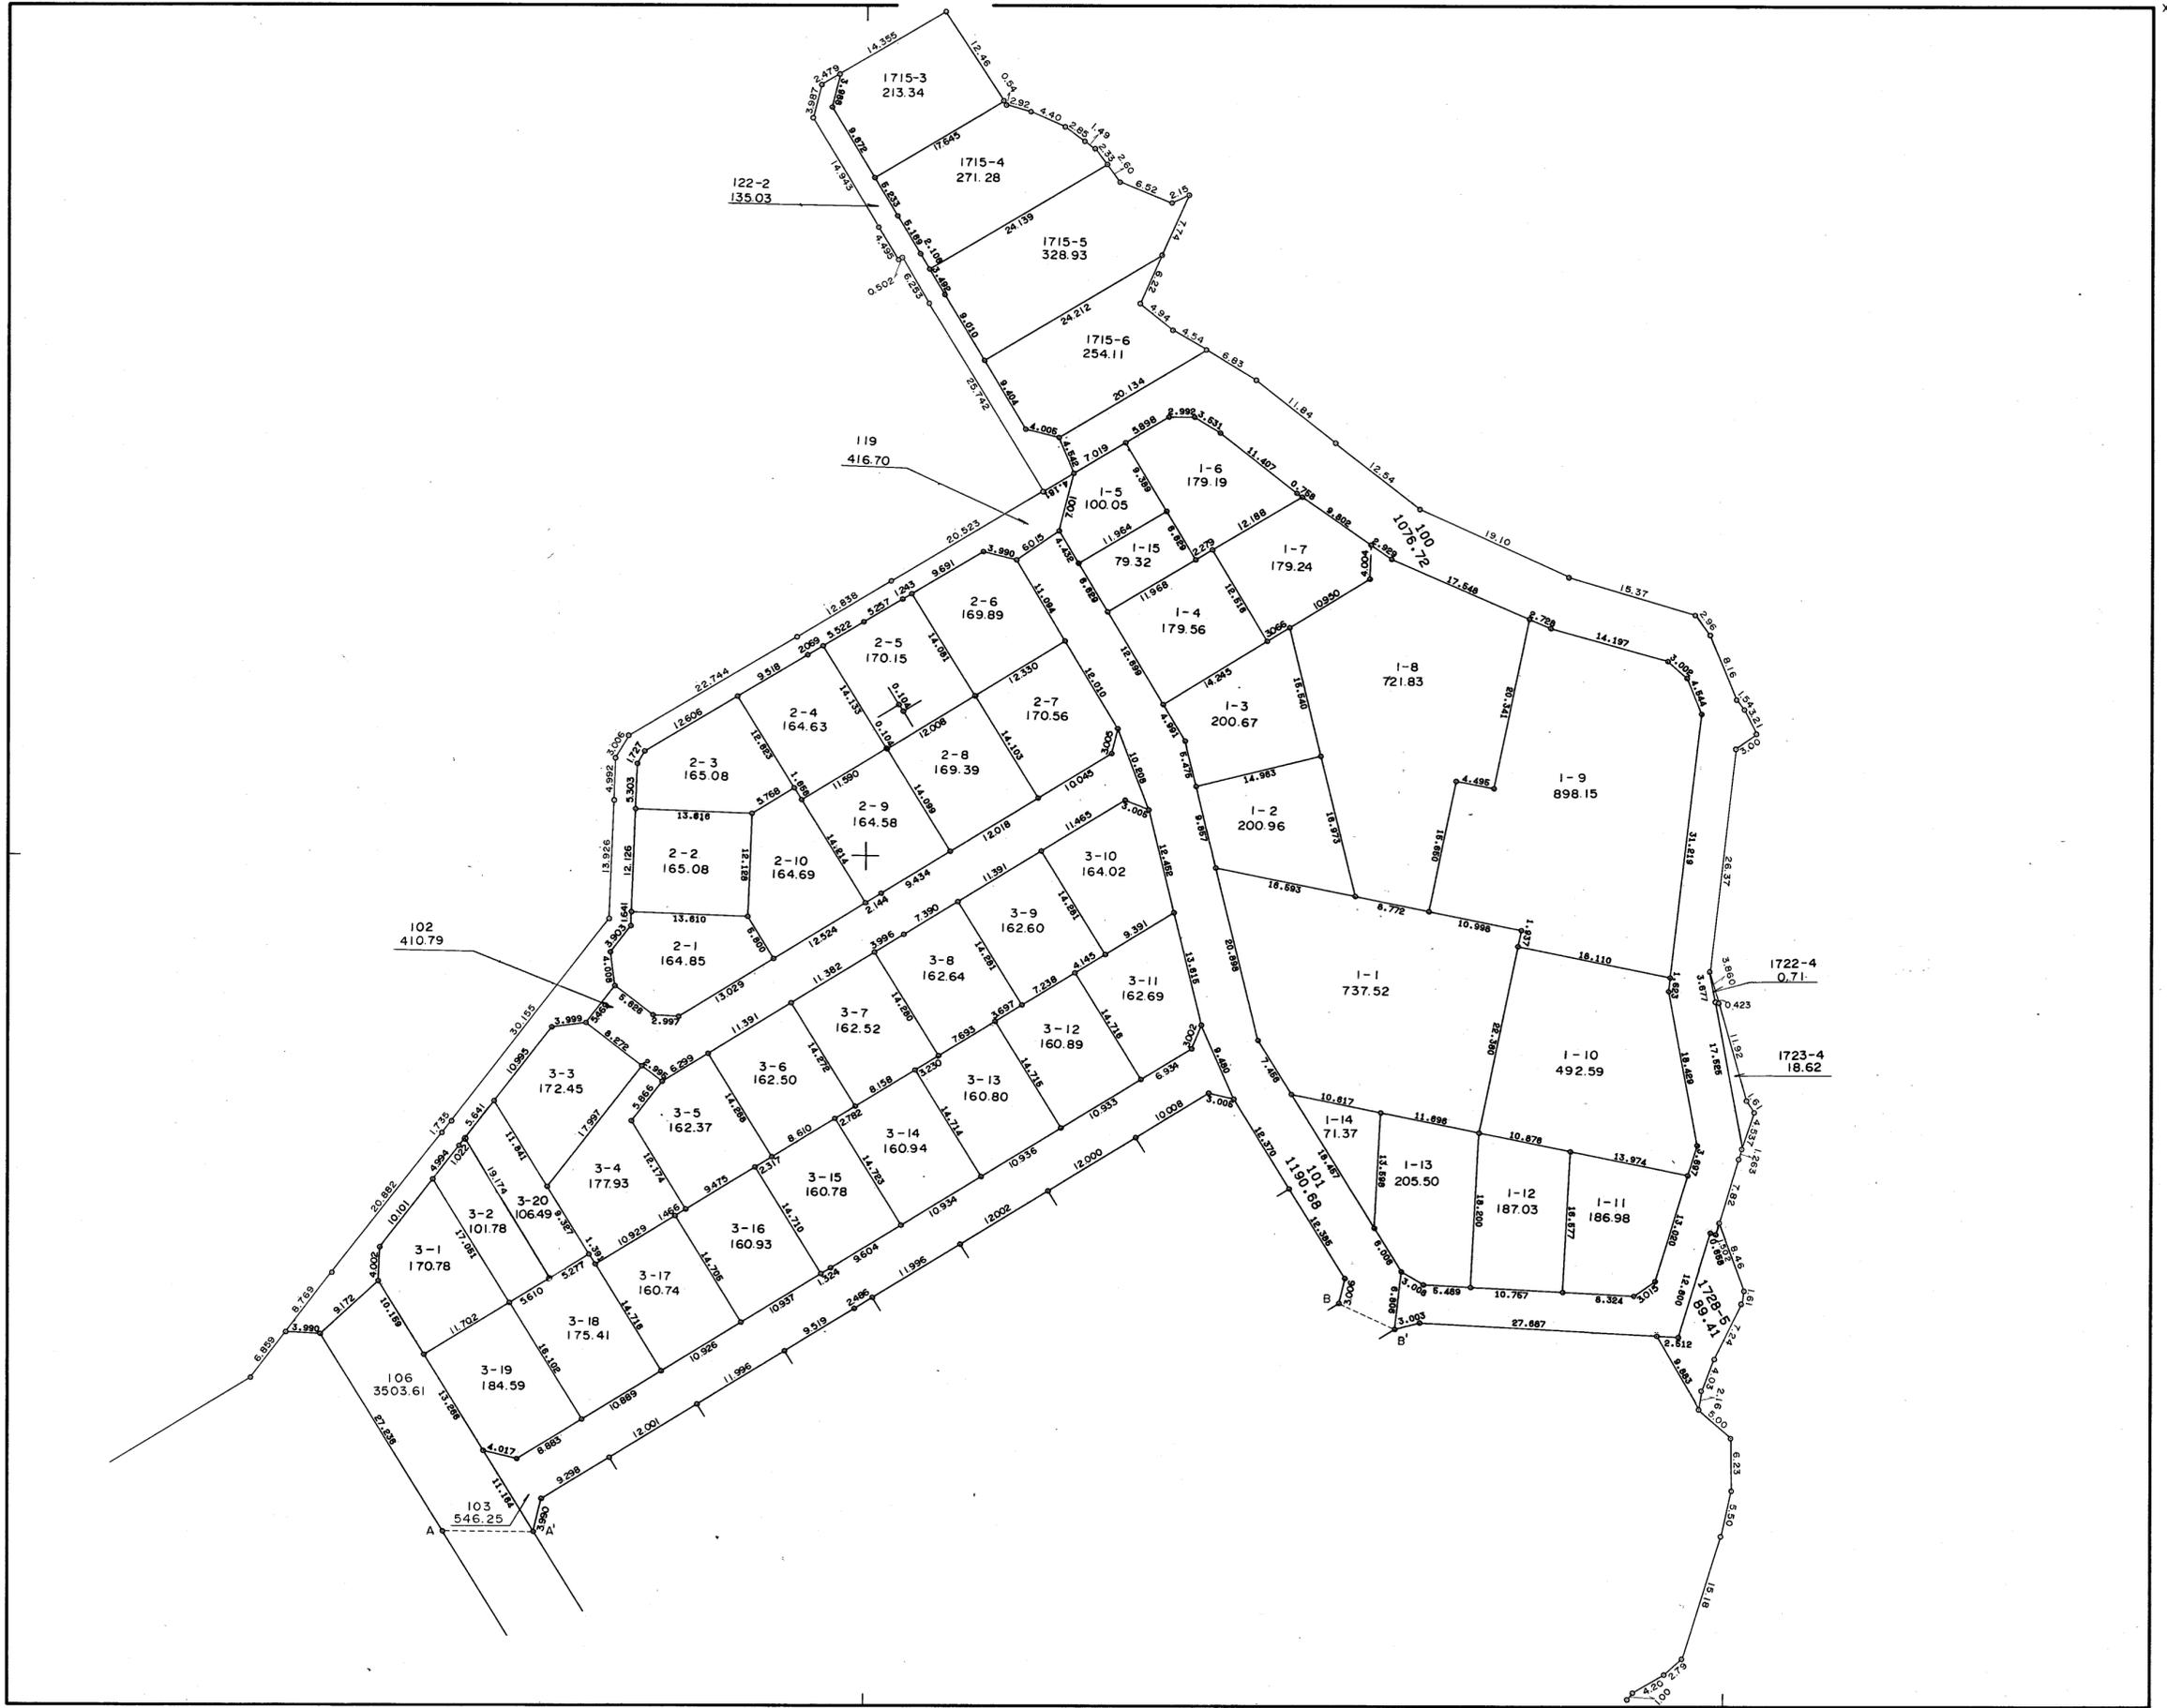


作業機関 株式会社 才才ハ

X=-64,000

Y=-28,700


計画機関 西田第二地区画整理組合

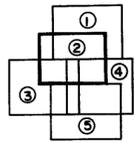

西田第二地区画地出来形確認測量原図

NO.2

Y=-28,500
X=-63,900

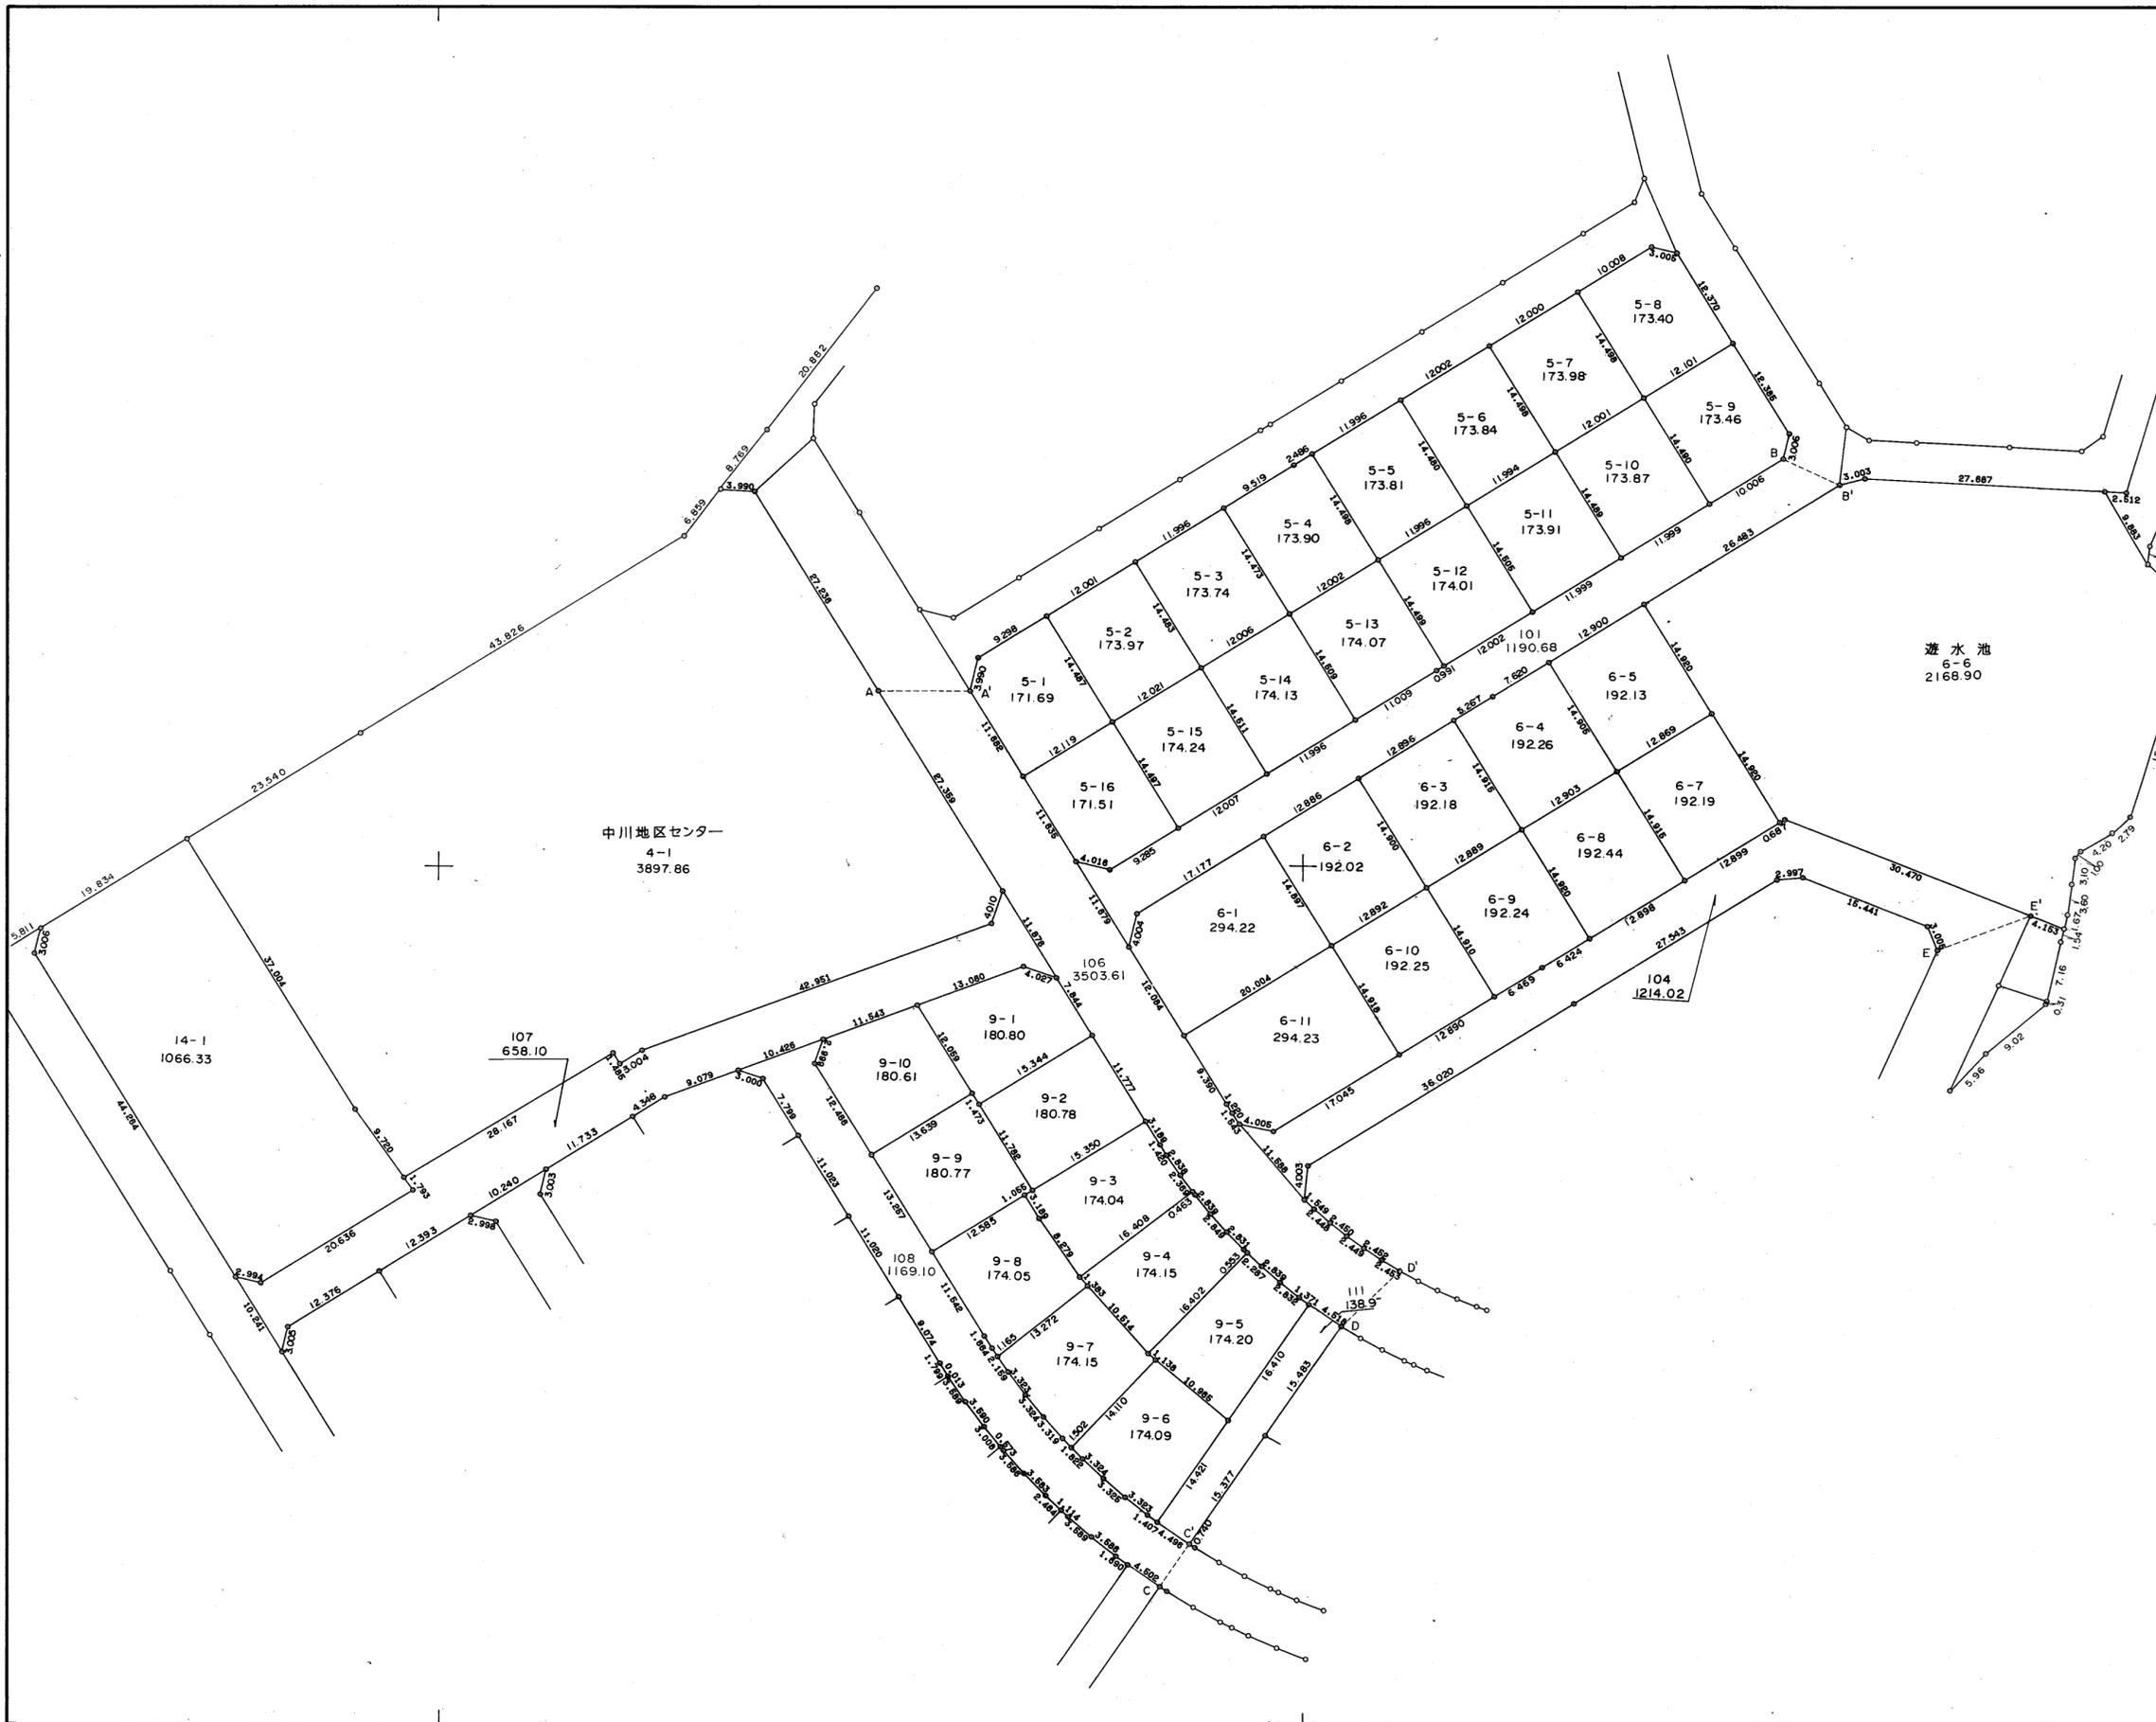


作業機関 株式会社 才オバ

計画機関 西田第二地区画整理組合

X=-64,100


Y=-28,750

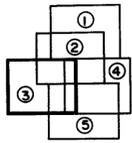

西田第二地区画地出来形確認測量原図

NO.3

Y=-28,600
X=-64,000

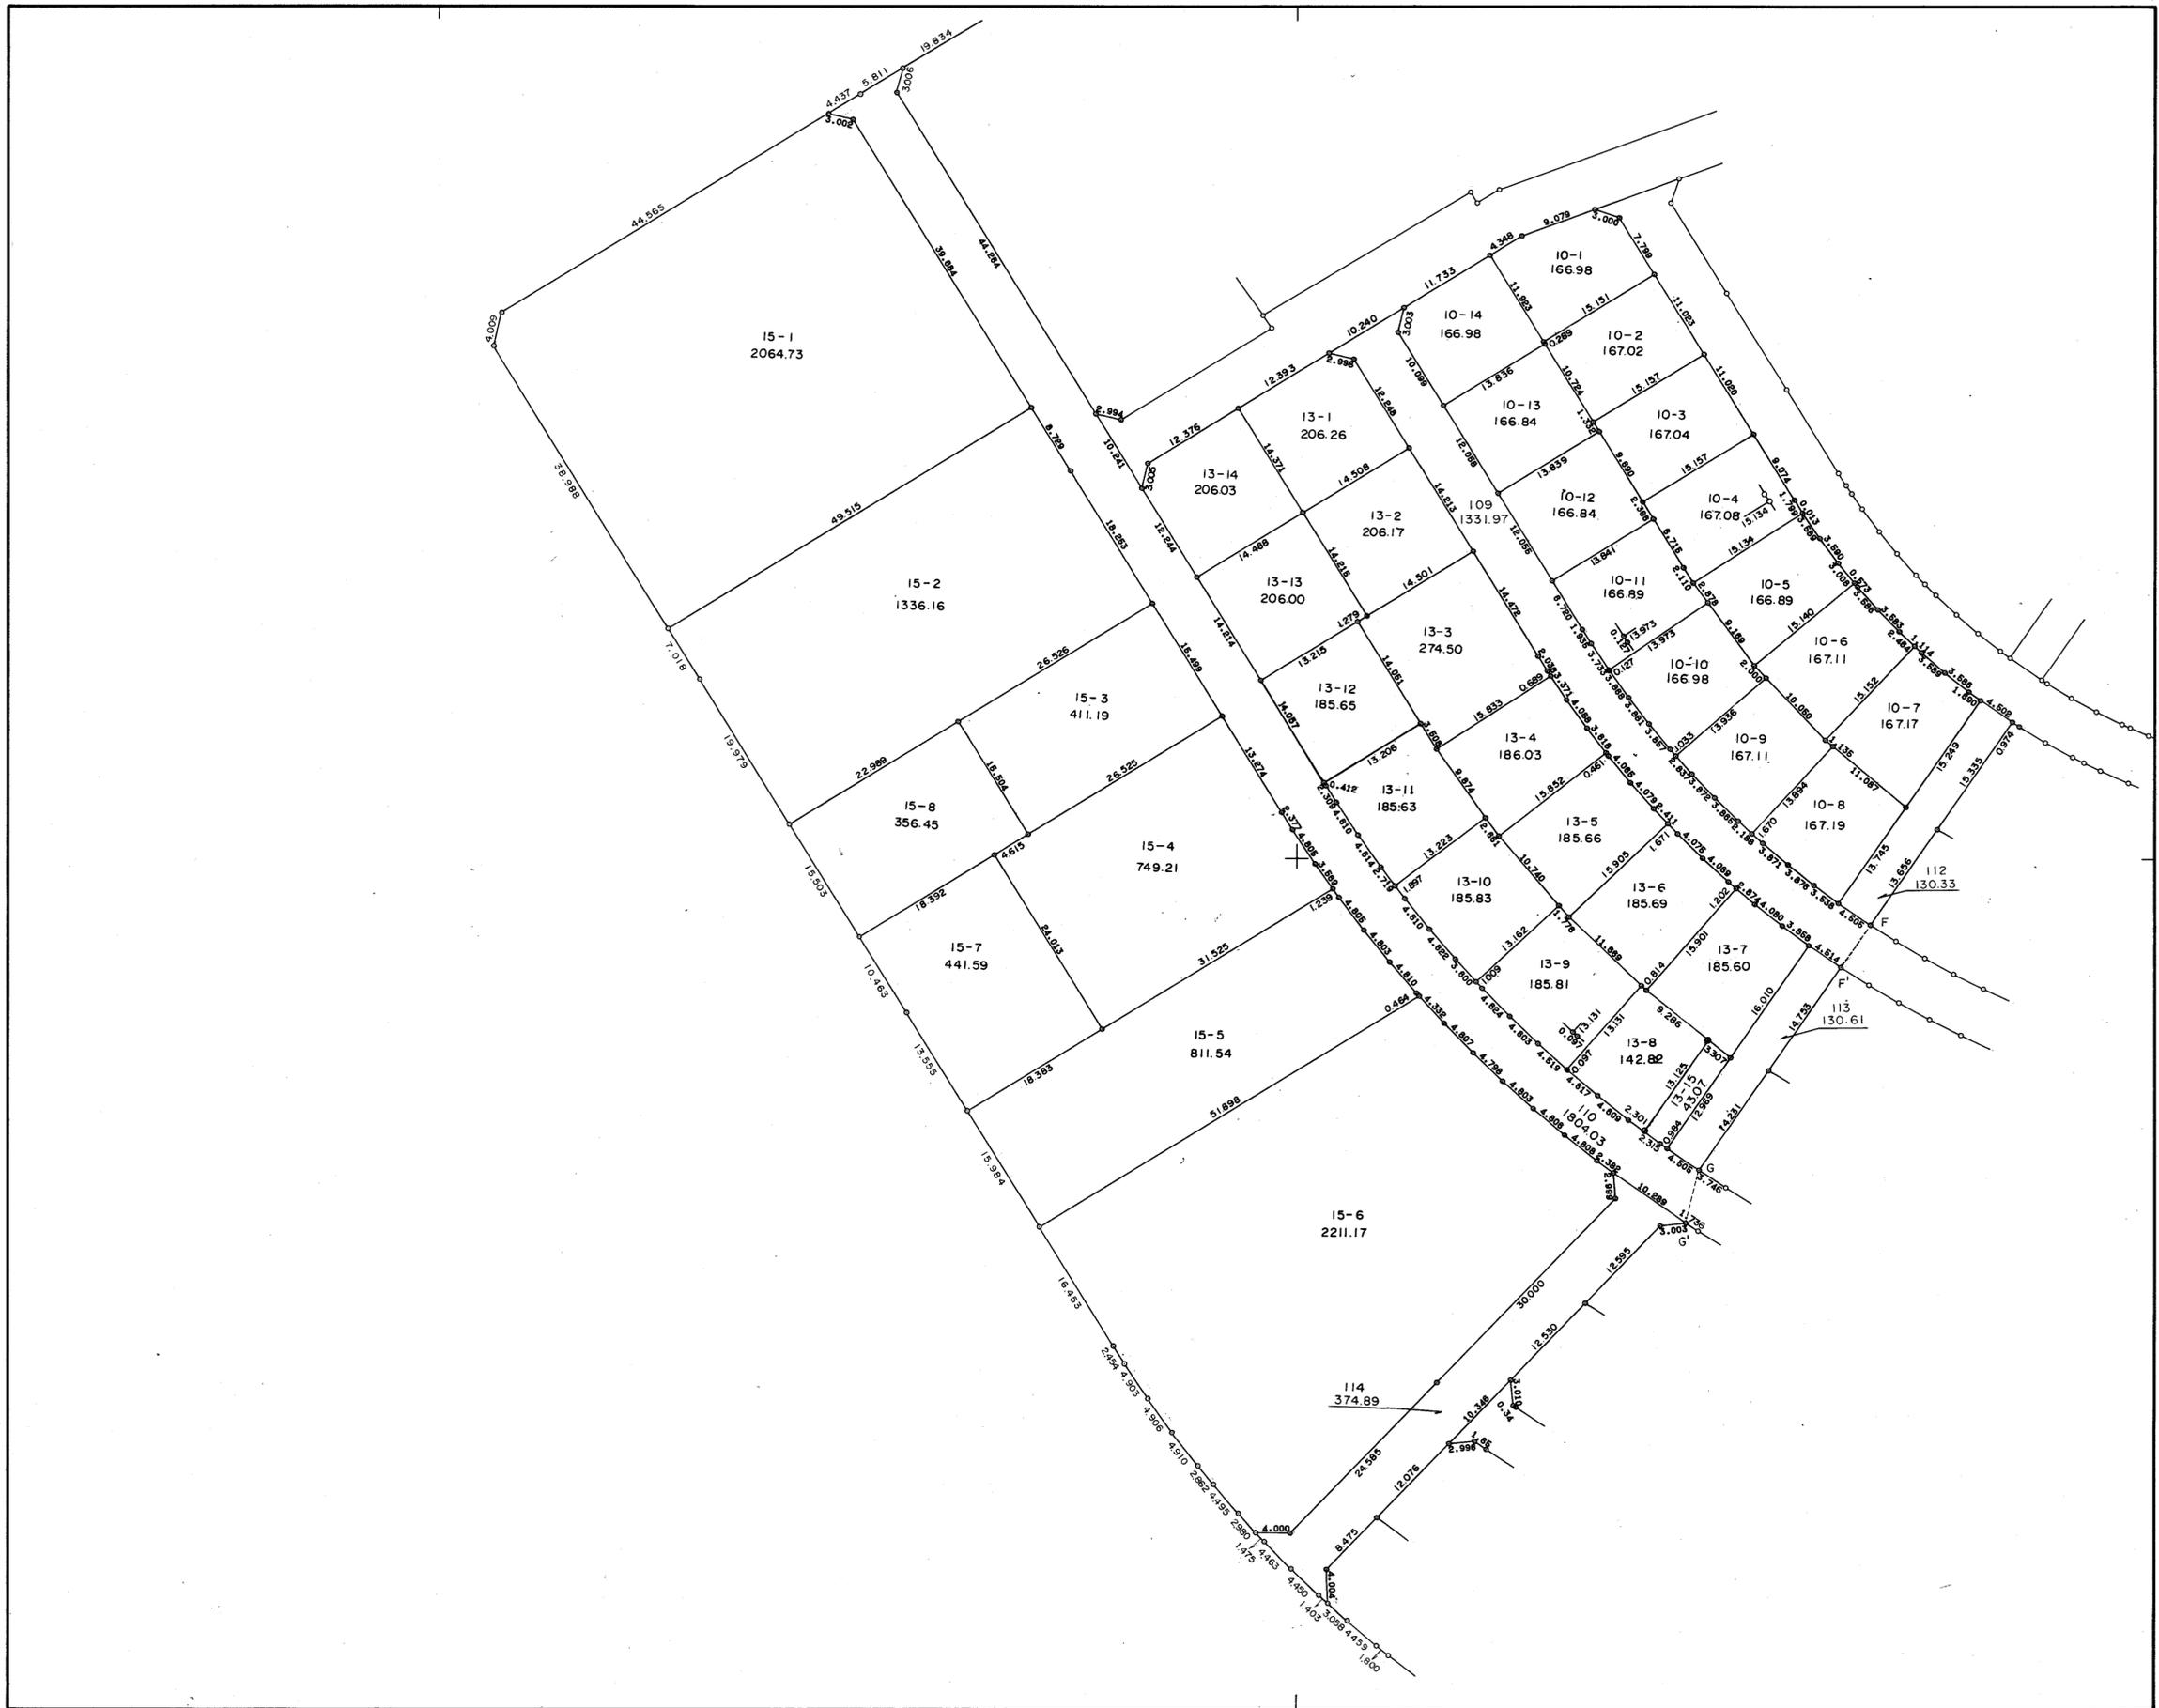


作業機関 株式会社 オオバ

計画機関 西田第二地区画整理組合

X=-64,200


Y=-28,500

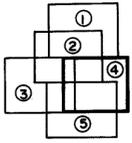

西田第二地区画地出来形確認測量原図

NO.4


Y=-28,400
X=-64,000

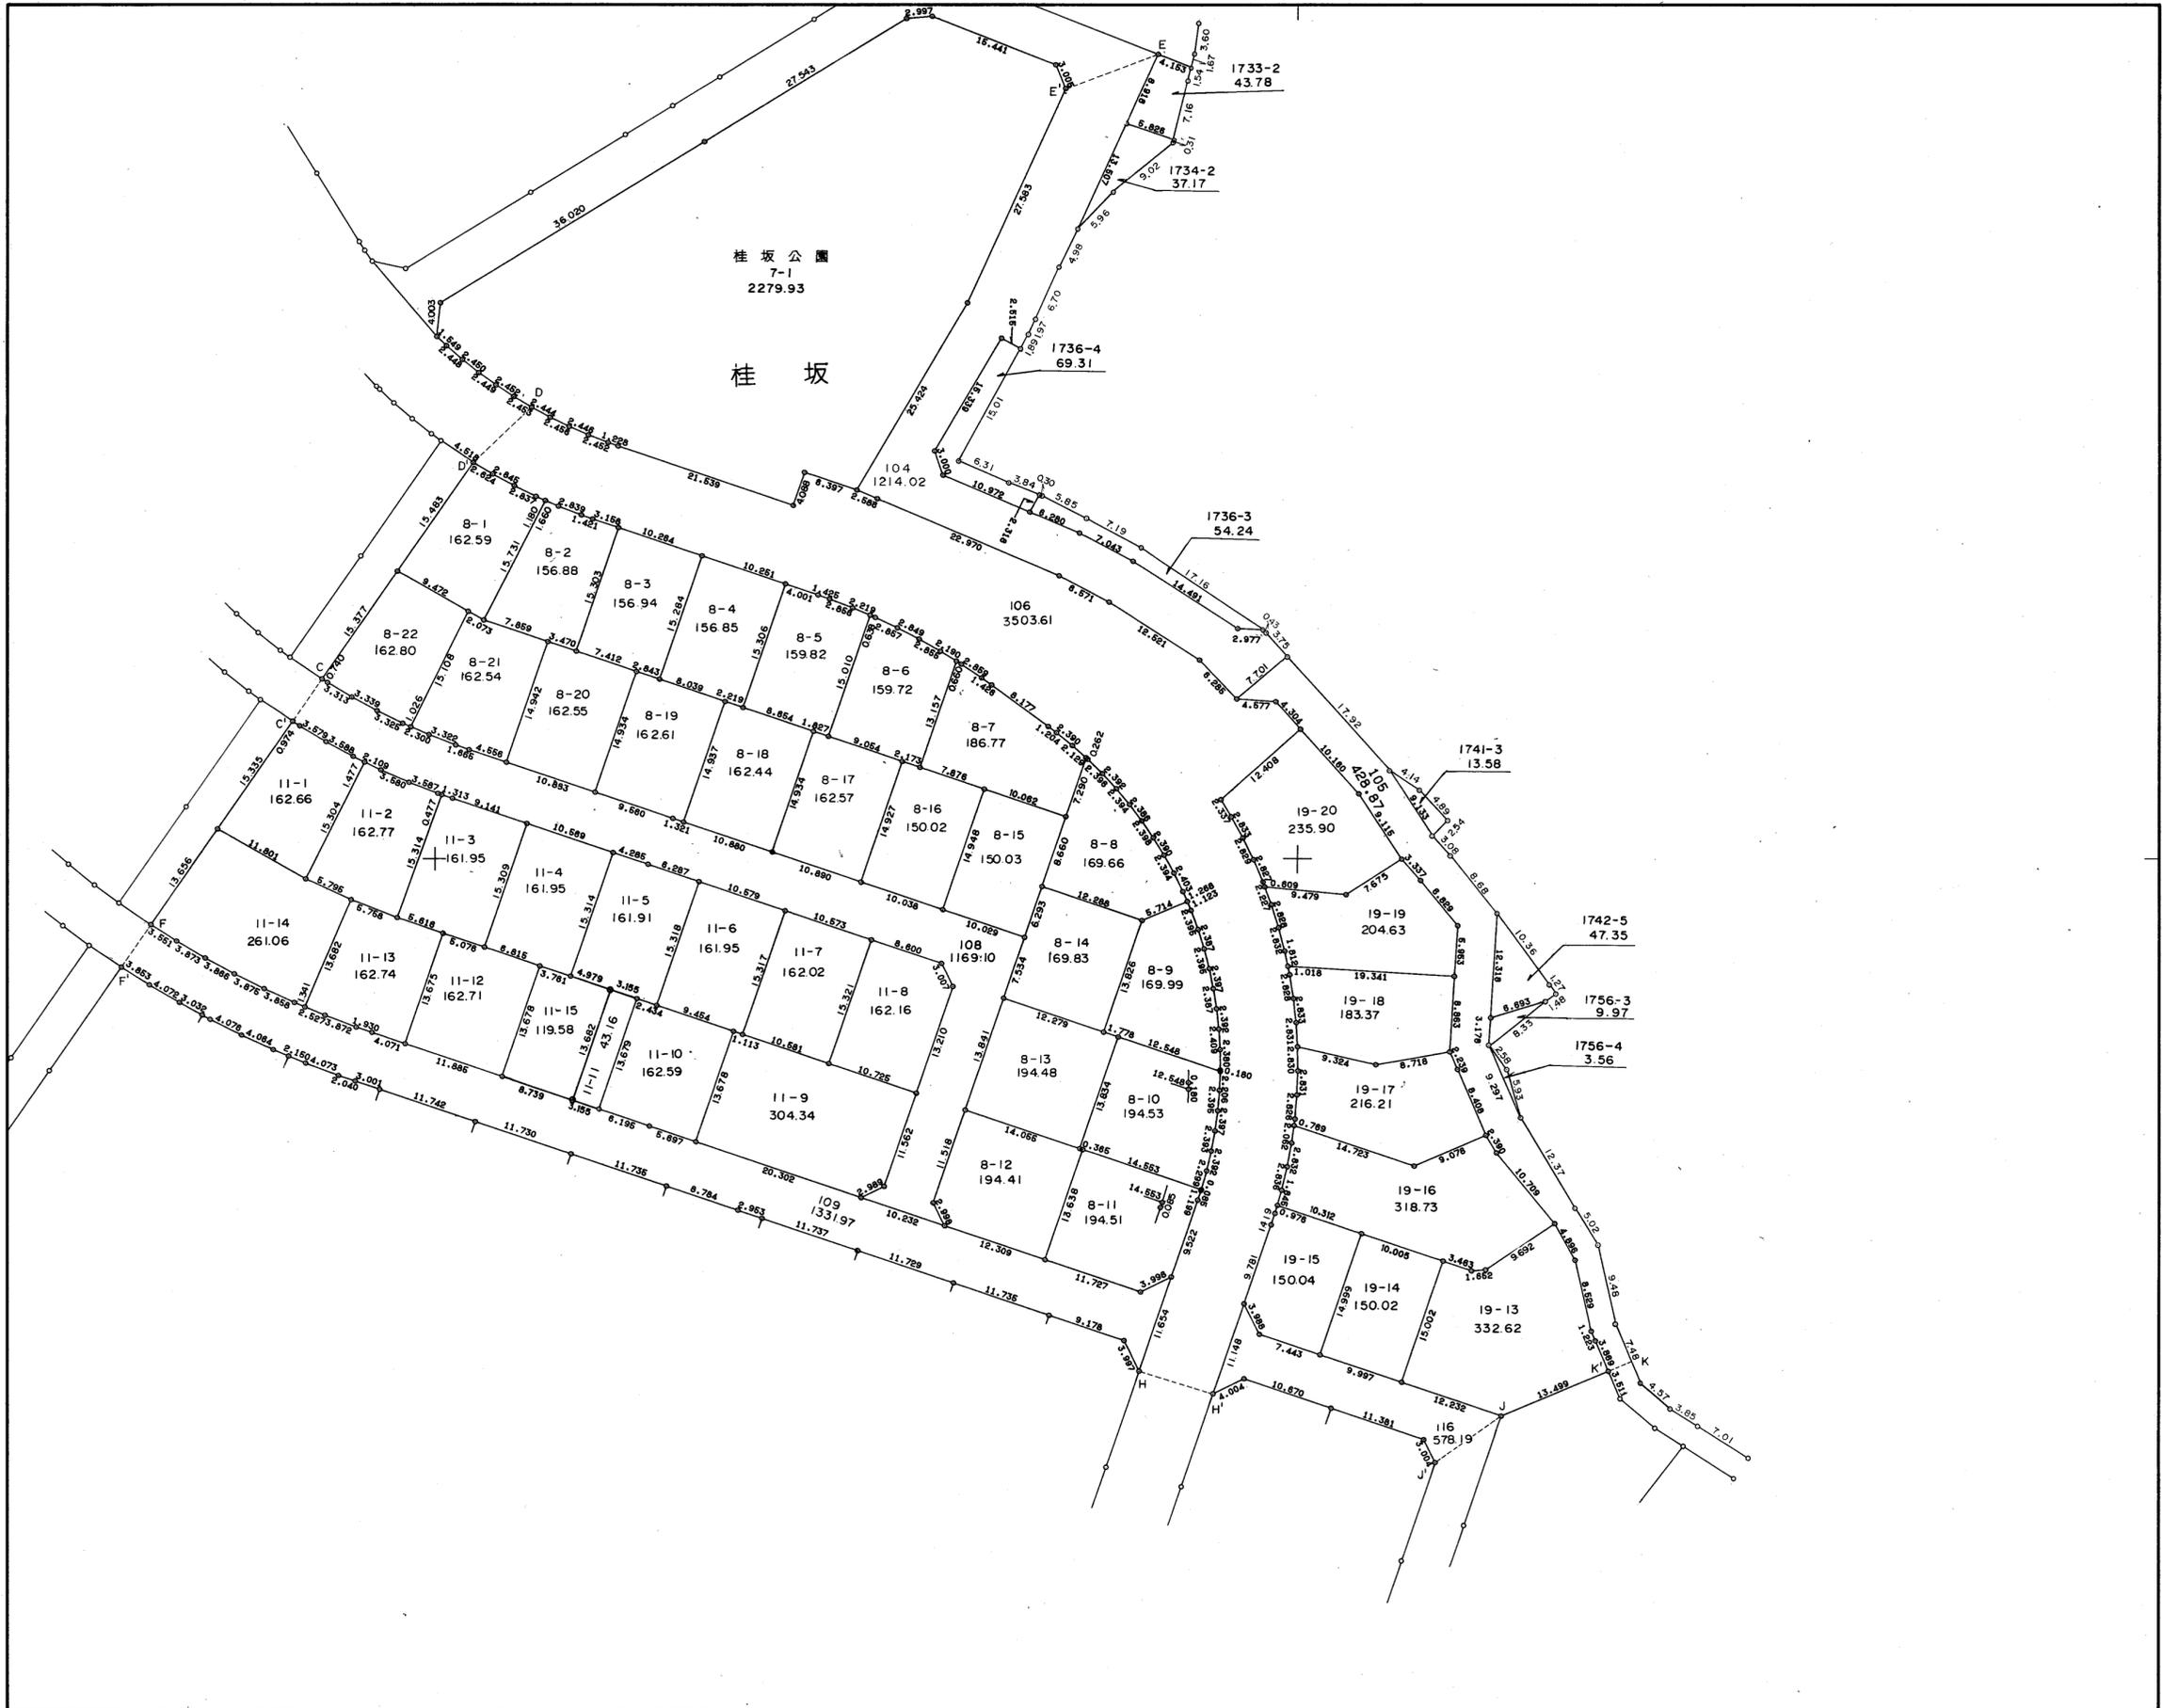

計画機関 西田第二地区画整理組合

X=-64,200


Y=-28,650

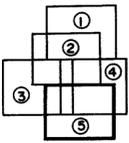

西田第二地区画地出来形確認測量原図

NO.5

Y=-28,450
X=-64,100

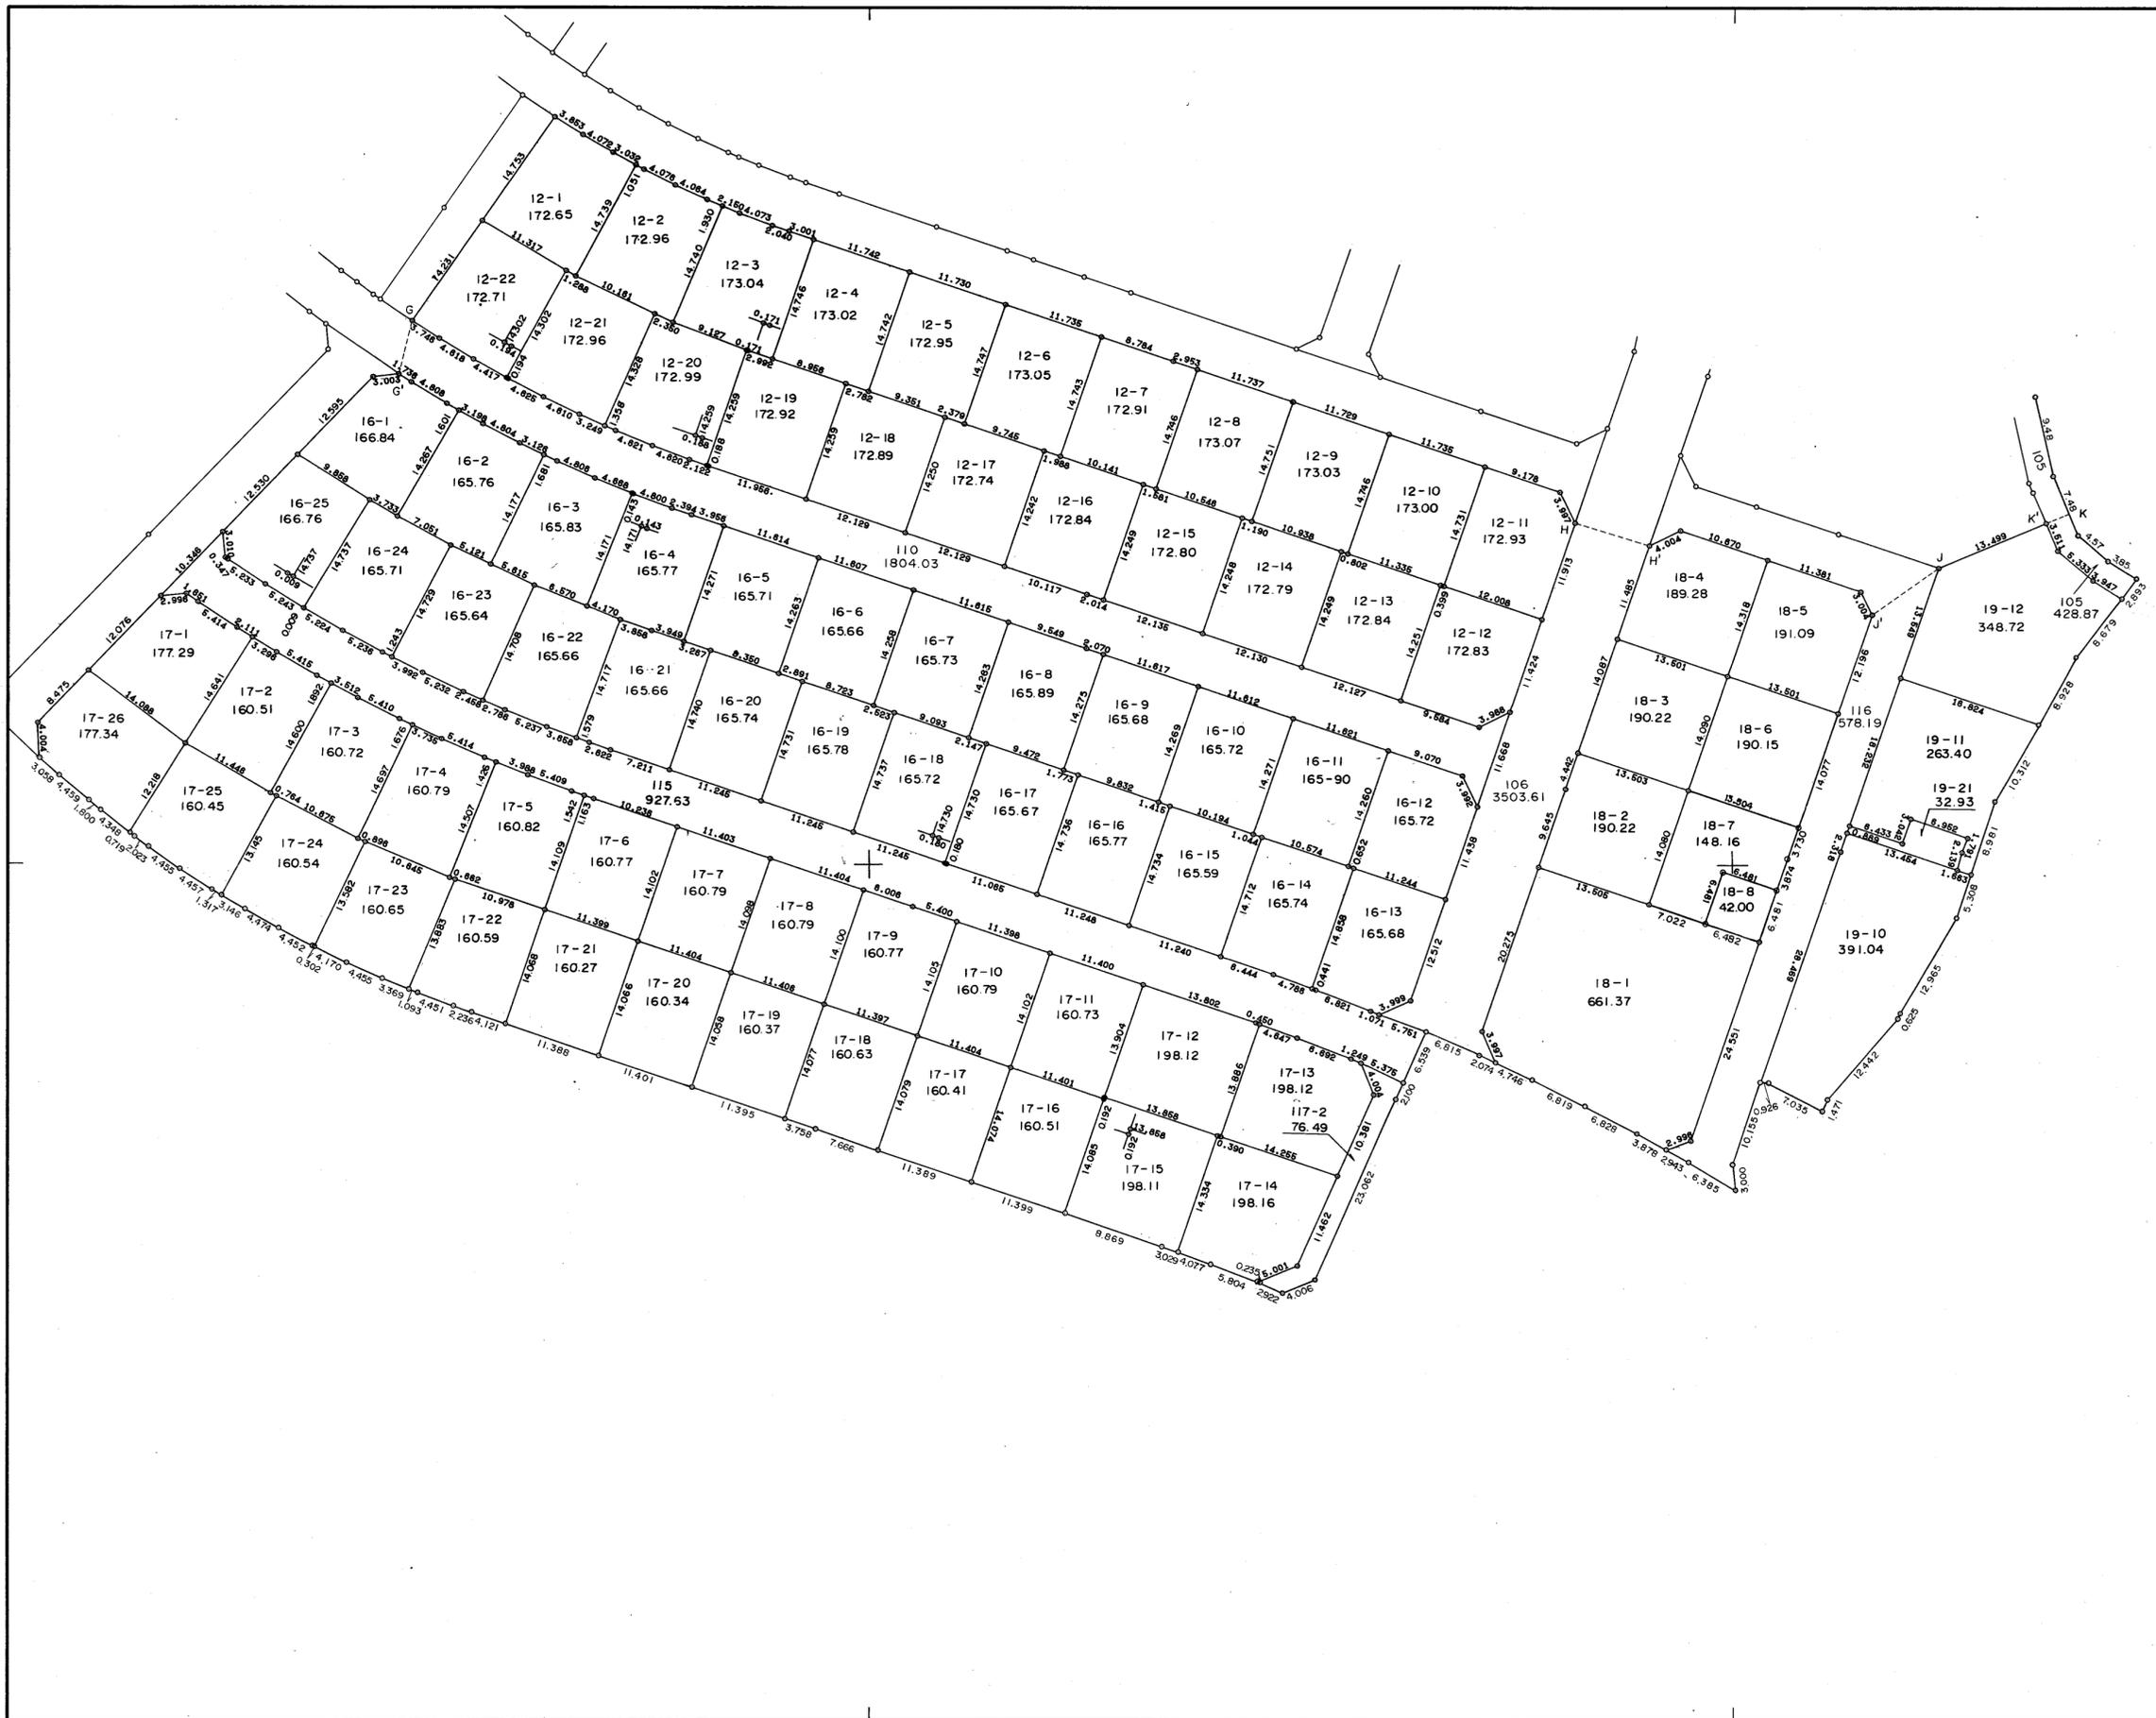

作業機関 株式会社 才才バ

Y=-64,300

Y=-28,700

計画機関 西田第二地区画整理組合